

# CERTIFICATE OF COMPLETION


Per # 9321PI



**Williamson County**  
**Department of Sewage Disposal**  
**Management**  
 1320 West Main Street, Suite 411  
 Franklin, TN 37064  
 (615) 790-5751  
 www.williamsoncounty-tn.gov

Prop. address: 586 NATCHEZ BEND RD.	System type: CONVENTIONAL
Owner: LINDA DOPP	Installation type: REPAIR
Issued to: LINDA DOPP	Installer: GARY MOORE
Subdivision: NATCHEZ HILLS	Septic tank vol.: 1250
Lot No.: 5	Absorption rate (M.P.I.): 60
Permit I.D. no.: 30869	DATE: 7/13/12
GIS. No.: 015----02100	

R:\PROPERTY SEPTIC RECORDS\WARS 11 - 2010\15 - 02100\015 - 02100\_COC.dwg, 8.5X11 PLOTTRAIT, 7/13/2012 2:48:30 PM

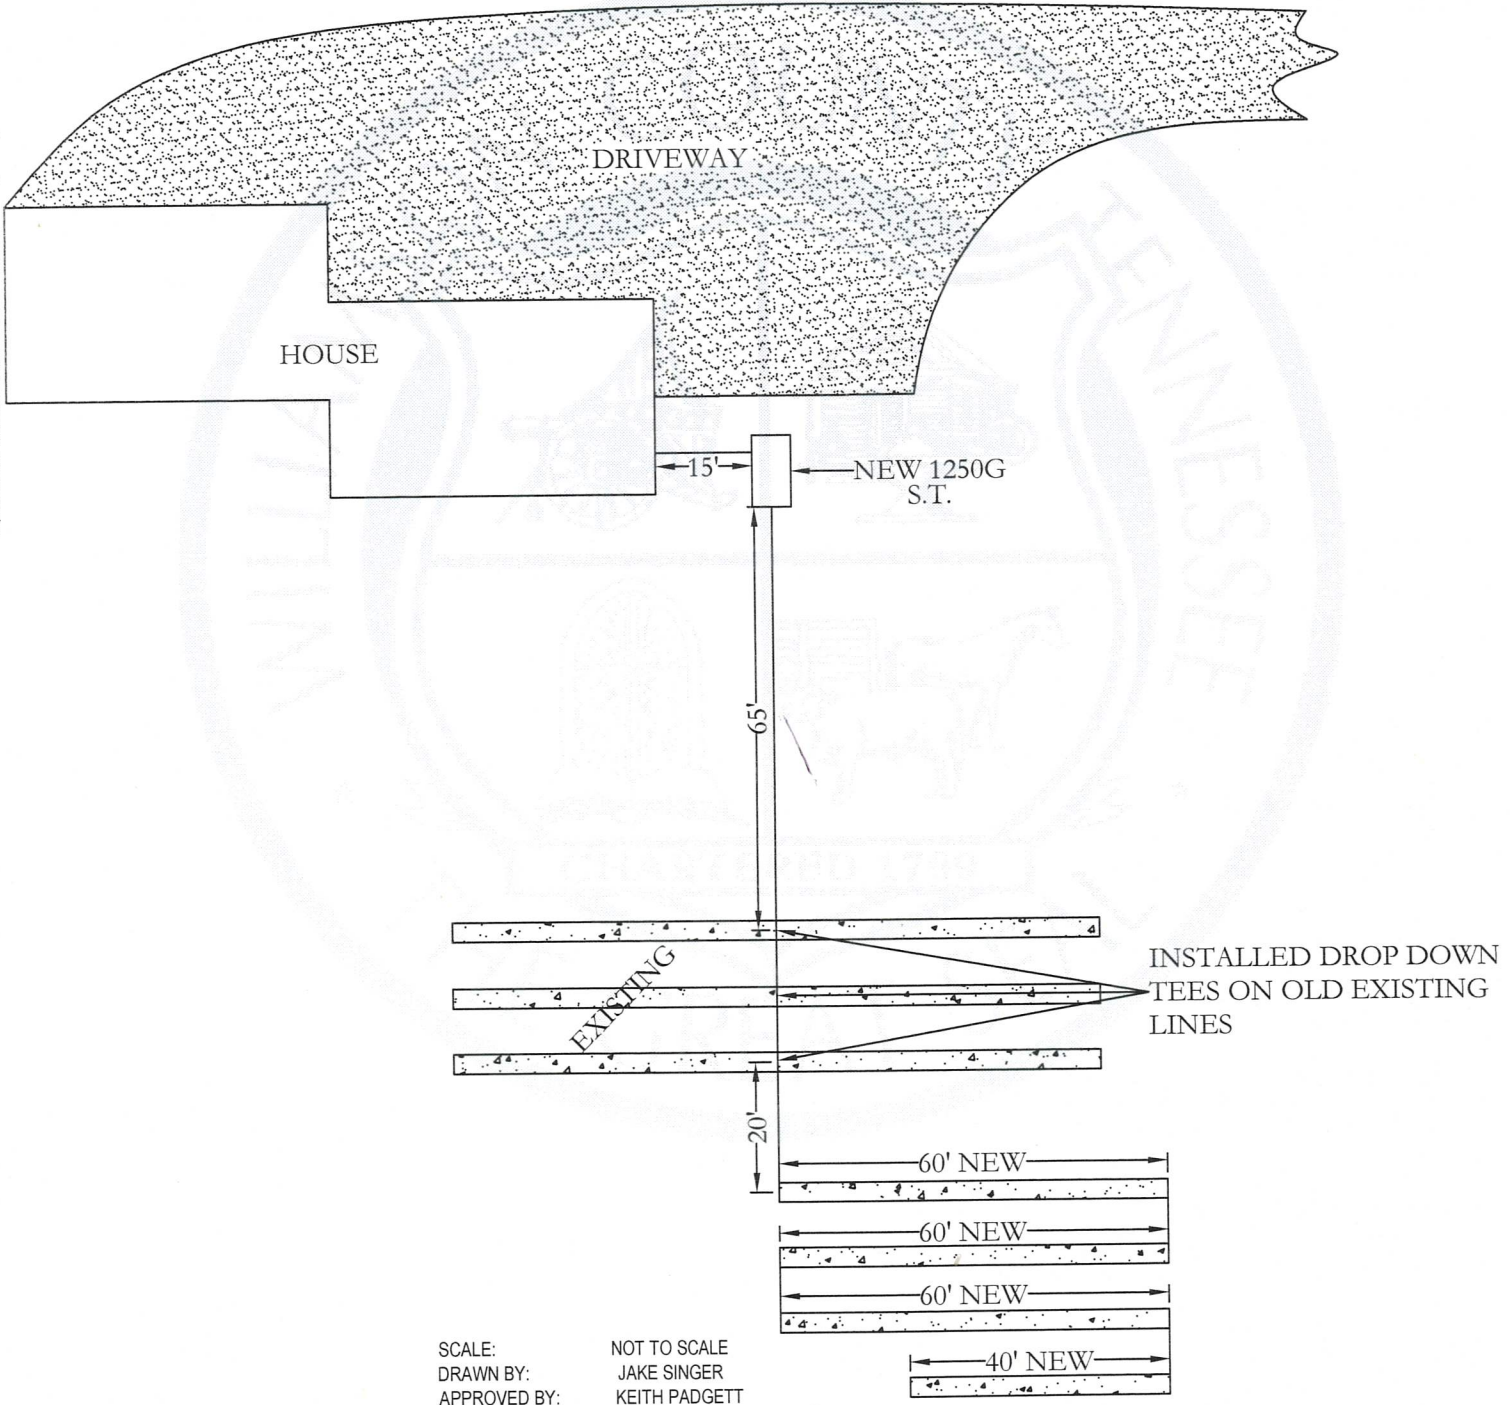

SCALE: NOT TO SCALE  
 DRAWN BY: JAKE SINGER  
 APPROVED BY: KEITH PADGETT  
 TITLE: INSPECTOR  
 SIGNATURE: *Keith Padgett*



Williamson County Department Of  
**SEWAGE DISPOSAL MANAGEMENT**  
 1320 West Main Street - Suite 411  
 Franklin, Tennessee 37064  
 Voice: 615.790.5751 FAX: 615.595.1293

**PERMIT FOR CONSTRUCTION  
 OF SUBSURFACE SEWAGE  
 DISPOSAL SYSTEM**

(Permit void three (3) years after date of issue)

Issued to: DOPP LINDA

ID no. 30869

Gis no: 015 021.00

Location:

Subdivision: NATCHEZ HILLS EST 5-A

Street Address: NATCHEZ BEND RD 586

Installation:

New

Repair

Capacities:

Septic tank: 1250

Pump tank:

Establishment:

Residential

Other

BDR: 3

OST: 1-52 & 1-86

GPD:

Soil Evaluation Basis: SOIL TYPING BY SOILS SCIENTIST - EXTRA HIGH INTENSITY

Estimated absorption rate:

60

MPI

Type of System:

CONVENTIONAL

Other description: MLPP BACK UP AREA

Notes:

BOTH OF THE EXISTING SEPTIC TANKS MUST BE PUMPED AND PROPERLY ABANDONED. A NEW 1250 GALLON SEPTIC TANK IS TO BE INSTALLED IN LOCATION AS SHOWN ON DESIGN PLANS BY ROGER FUQUA. THE TANK LOCATION IS TO ACCOMMODATE THE FUTURE USE OF THE RESERVE MLPP AREA. INSTALL DROP DOWN TEES ACROSS THE THREE EXISTING FIELD LINES AND THEN ADD 216 LINEAR FEET OF FIELD LINE FOOTAGE IN THE AREA SHOWN ON THE RECORDED PLAT. THE INSTALLER MUST CONTACT BART SKELTON TO SCHEDULE AN ON-SITE LAYOUT PRIOR TO SYSTEM REPAIR. THE INSTALLER MUST CONTACT THE WILLIAMSON COUNTY DEPARTMENT OF SEWAGE DISPOSAL MANAGEMENT PRIOR TO SYSTEM TO INITIATE THE PERMIT TO INSTALL PROCESS. SEE DESIGNS FOR DETAILS.

The recipient of this permit agrees to construct or have constructed the system described above in accordance with the Regulations to Govern On-Site Sewage Disposal Systems of the Williamson County Department of Sewage Disposal Management, as operated under the auspices of the Williamson County Board of Health, and T.C.A. 68-221-401 et seq. All installers of subsurface sewage disposal systems must hold a valid annual license from the Williamson County Department of Sewage Disposal Management.

Signature

*[Handwritten Signature]*

(Signature of Recipient)

Date

4-21-2010

Issued by

BART H SKELTON

*[Handwritten Signature]*  
 (Name)

SOIL SCIENTIST

(Title)

4/15/2010

(Date)